Memorandum

To: Mayor Elinor Carbone and Water Pollution Control Authority

CC: Carol Anderson


Victor Muschell Paul Kundzins Ed Tousey

From: Ray Drew, DPW

Date: 12/31/19

Re: Vote to Accept Tognalli Sanitary Sewer System

1. Vote by the City Council herein acting as the Water Pollution Control Authority to accept the recommendation of Director of Public Works and City Engineer to accept the sanitary sewer mainline on Tognalli Drive as a public sewer.

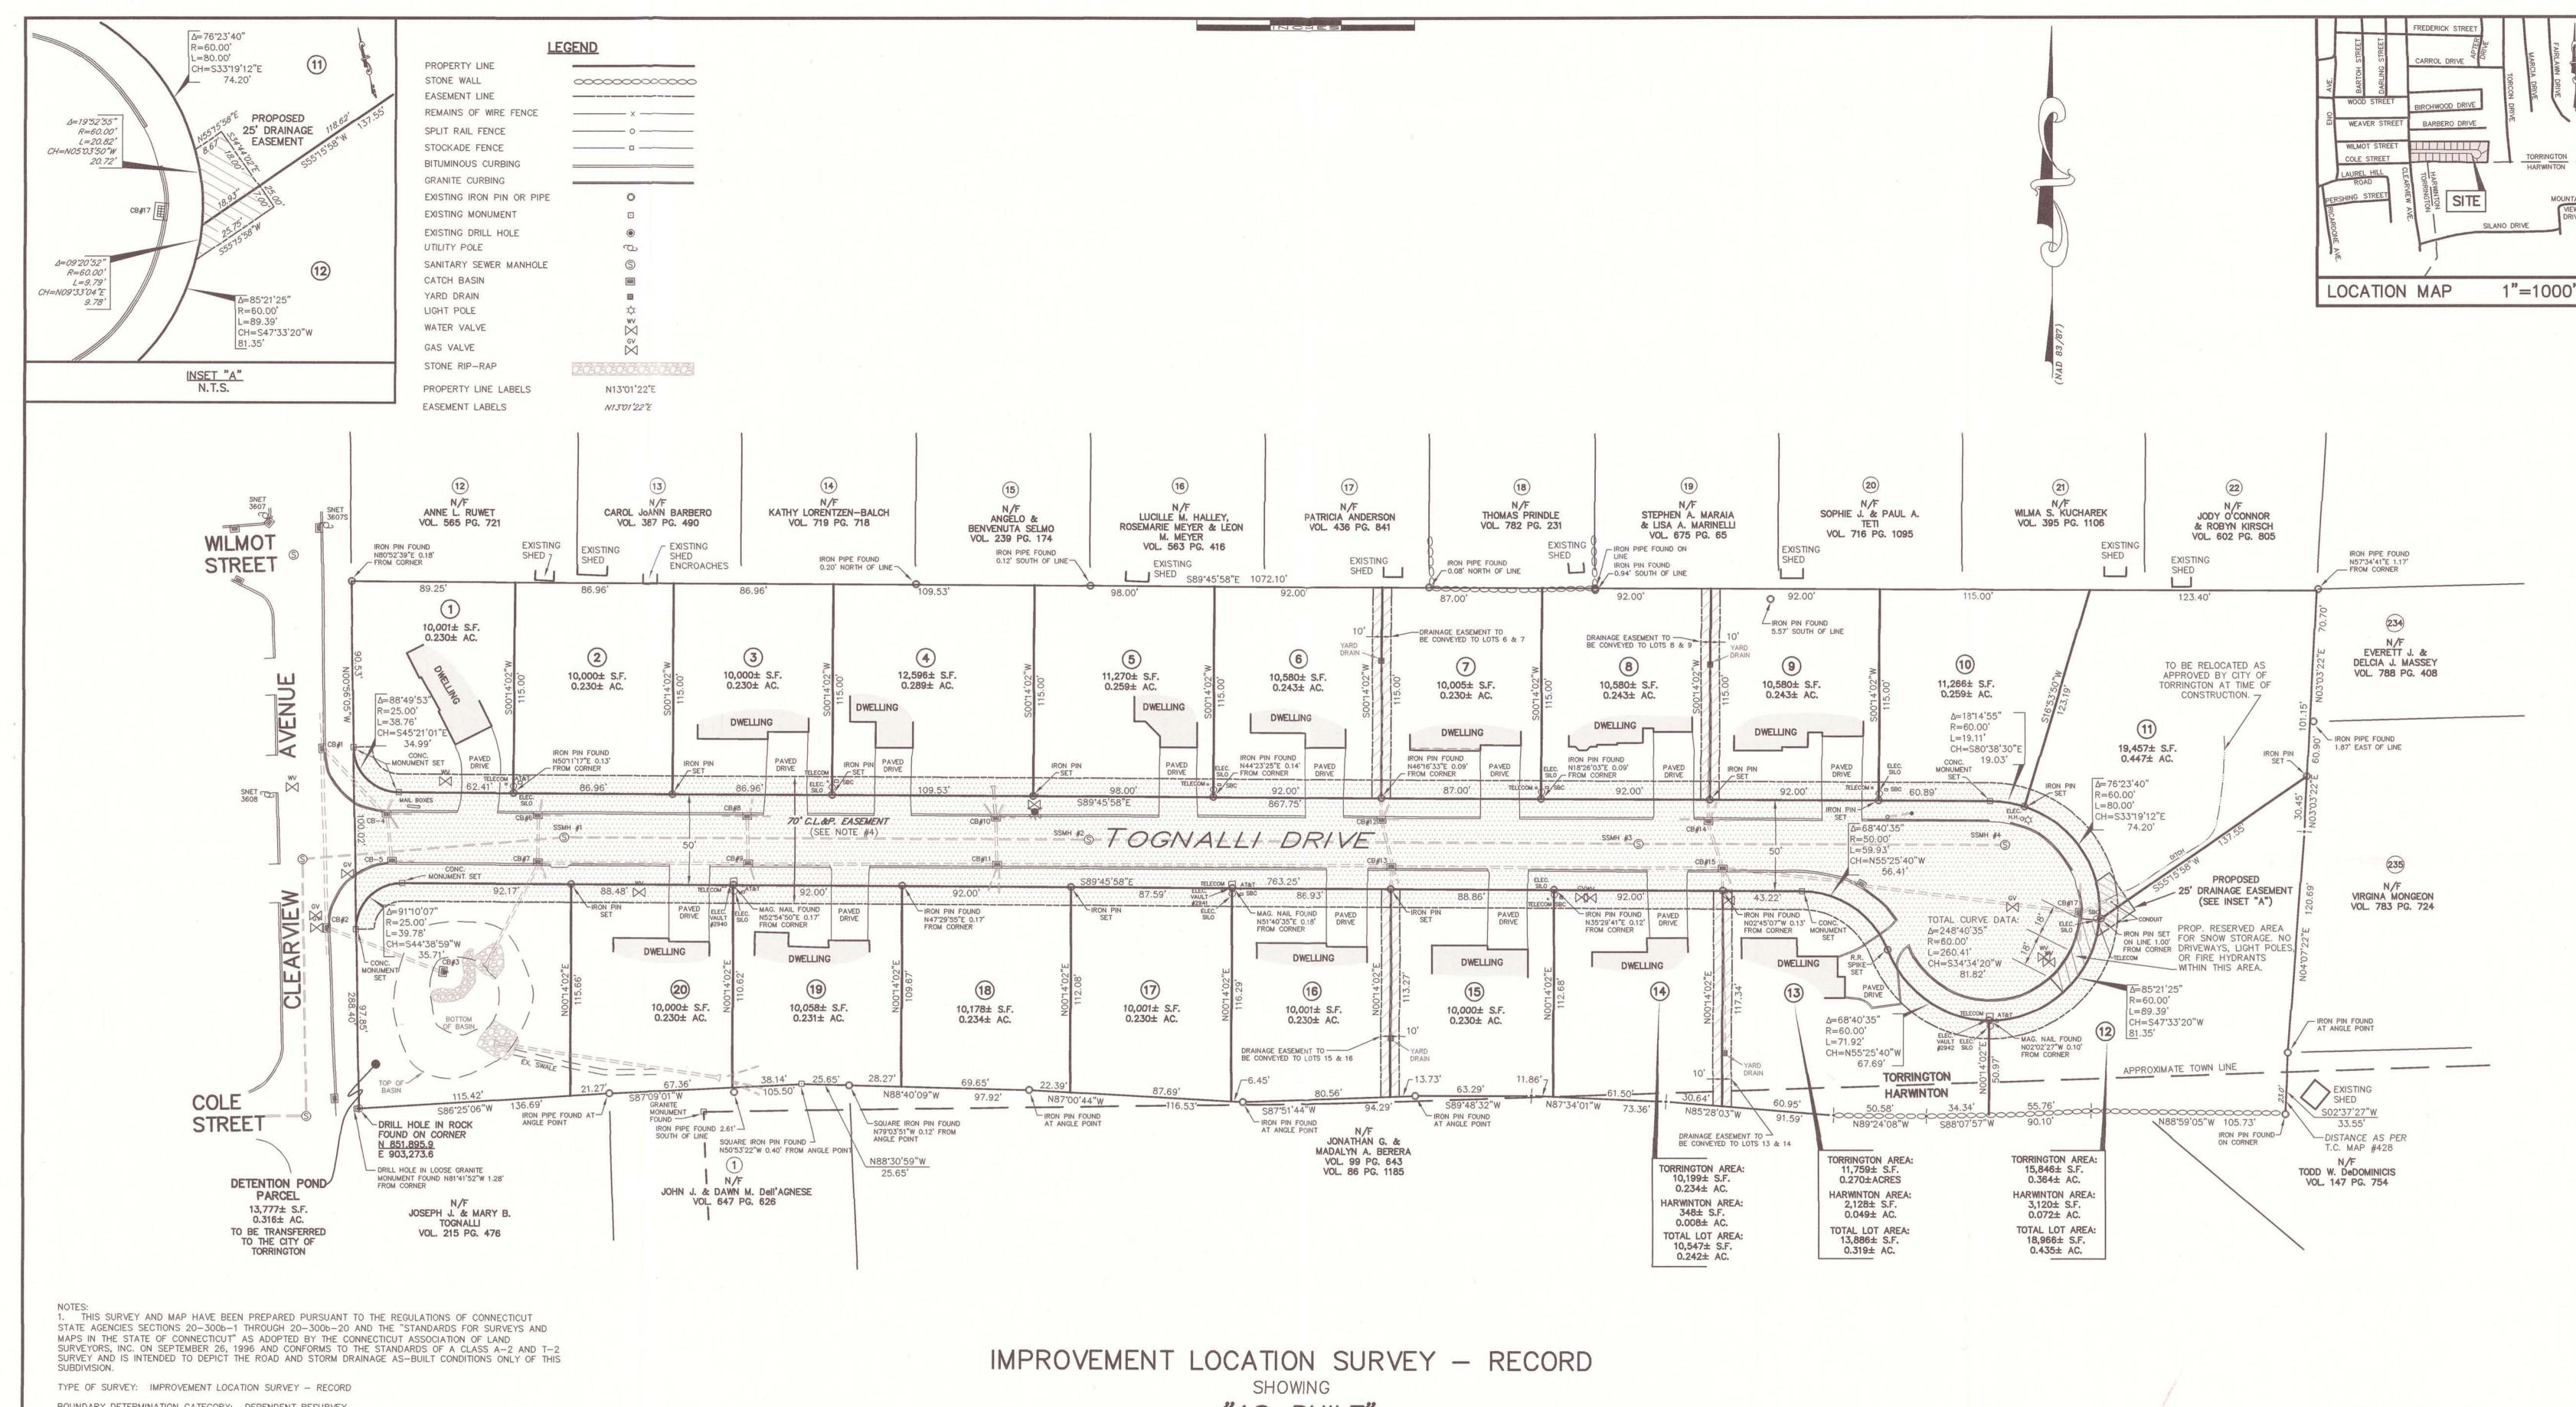

BOUNDARY DETERMINATION CATEGORY: DEPENDENT RESURVEY

OWNERS OF RECORD: T & M BUILDING CO., INC. REFER TO DEED VOLUME 928 PAGE 688 OF THE TORRINGTON LAND RECORDS.

- 3. REFER TO TOWN CLERK MAPS #428, #4983 AND #5115 OF THE TORRINGTON LAND RECORDS.
- REFER TO PLANS ENTITLED "CONSTRUCTION PLAN TOGNALLI DRIVE TORRINGTON CHASE PREPARED FOR T & M BUILDING CO., INC. CLEARVIEW AVENUE TORRINGTON, CONNECTICUT DATED 09/14/04 LAST REVISED 03/18/05 SCALE AS NOTED" AND PLAN ENTITLED "SITE DEVELOPMENT AND GRADING PLAN TORRINGTON CHASE PREPARED FOR T & M BUILDING CO., INC. CLEARVIEW AVENUE TORRINGTON, CONNECTICUT DATED 09/14/04 LAST REVISED 03/18/05 SCALE 1"=40" PREPARED BY THIS OFFICE.
- 5. REFER TO DEED VOLUME 998 PAGE 313 AND TOWN CLERK MAP #5115 OF THE TORRINGTON LAND RECORDS FOR EASEMENT IN FAVOR OF CONNECTICUT LIGHT AND POWER COMPANY.
- 6. PROPERTY LOCATED IN ZONE R10S.
- 7. THE INDIVIDUAL AREAS SHOWN HEREON FOR LOTS 12-14, THAT ARE BOTH IN THE CITY OF TORRINGTON AND THE TOWN OF HARWINTON, ARE BASED ON AN APPROXIMATE TOWN LINE LOCATION.
- 8. HORIZONTAL DATUM: (NAD 83/87), ACQUIRED BY GLOBAL POSITIONING SYSTEM (GPS) OBSERVATIONS. VERTICAL DATUM: PER PLANS REFERENCED IN NOTE #4.

"AS-BUILT"

TORRINGTON CHASE

PREPARED FOR

T & M BUILDING COMPANY, INC.


CLEARVIEW AVENUE AND TOGNALLI DRIVE TORRINGTON, CONNECTICUT SHEET 1 OF 2

SEE SHEET 2 OF 2 FOR DRAINAGE INFORMATION

"I HEREBY DECLARE THAT TO MY KNOWLEDGE AND BELIEF, THIS MAP IS SUBSTANTIALLY CORRECT AS NOTED HEREON.' DAVID J. ZYGMONT, L.S.

REVISED 05-28-19 ADD ADD DRAINAGE EASEMENT REVISED 04-17-19 ADD MONUMENTATION FOUND & SET

Proj. No.: 03-990AB(SUB-AB1) Drawn By: DZ

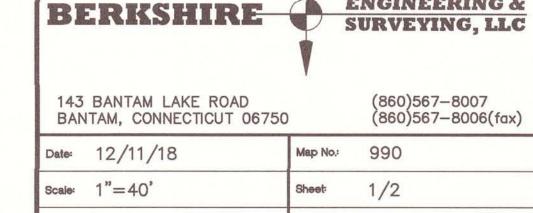

ENGINEERING &

